

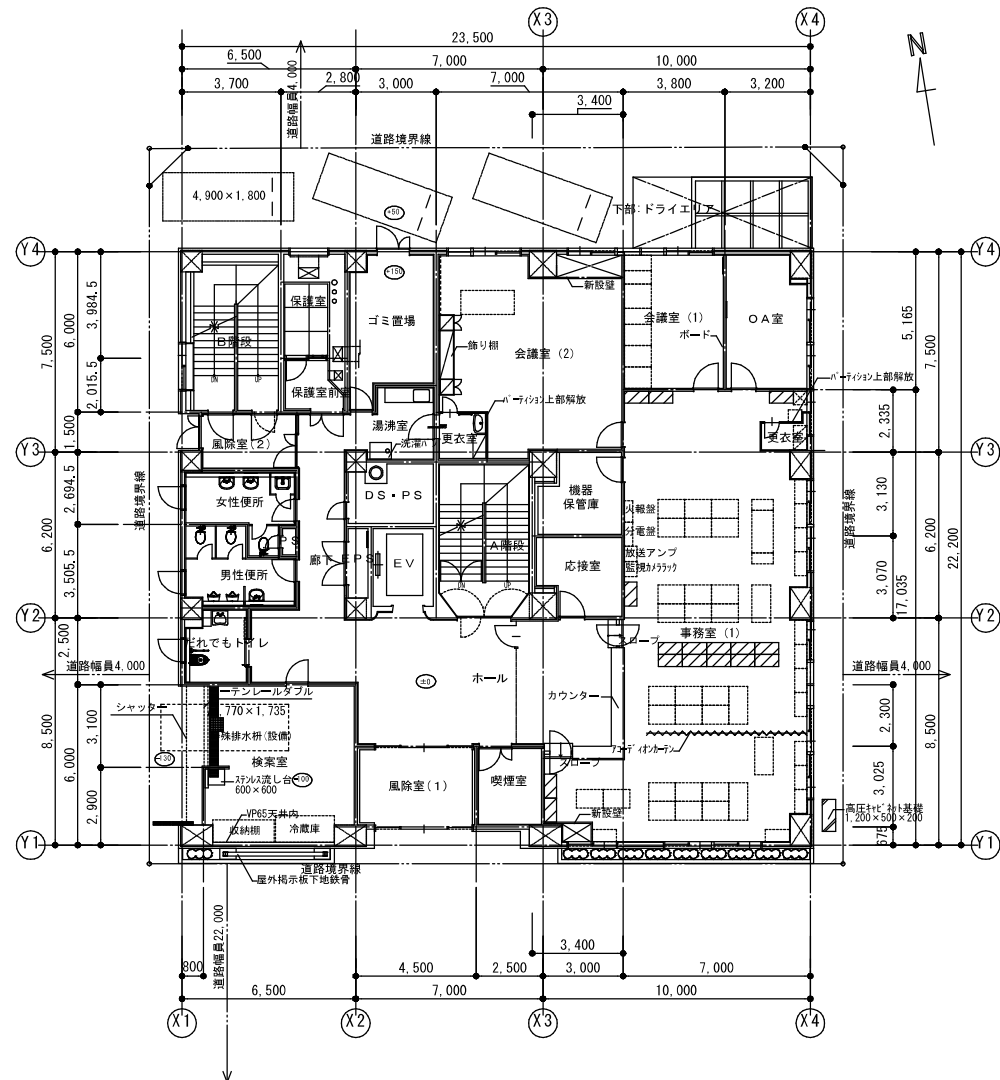



B1階平面図 521.7㎡

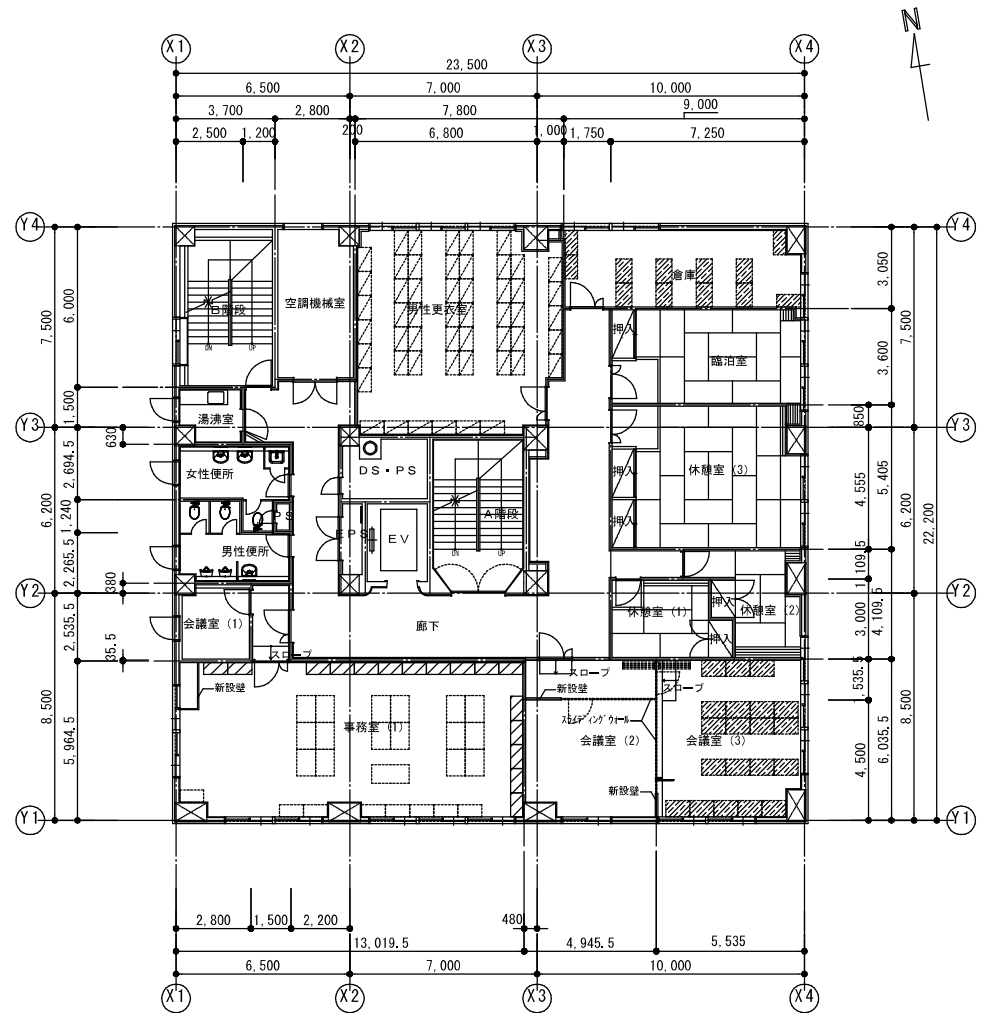

1階平面図 529.4㎡

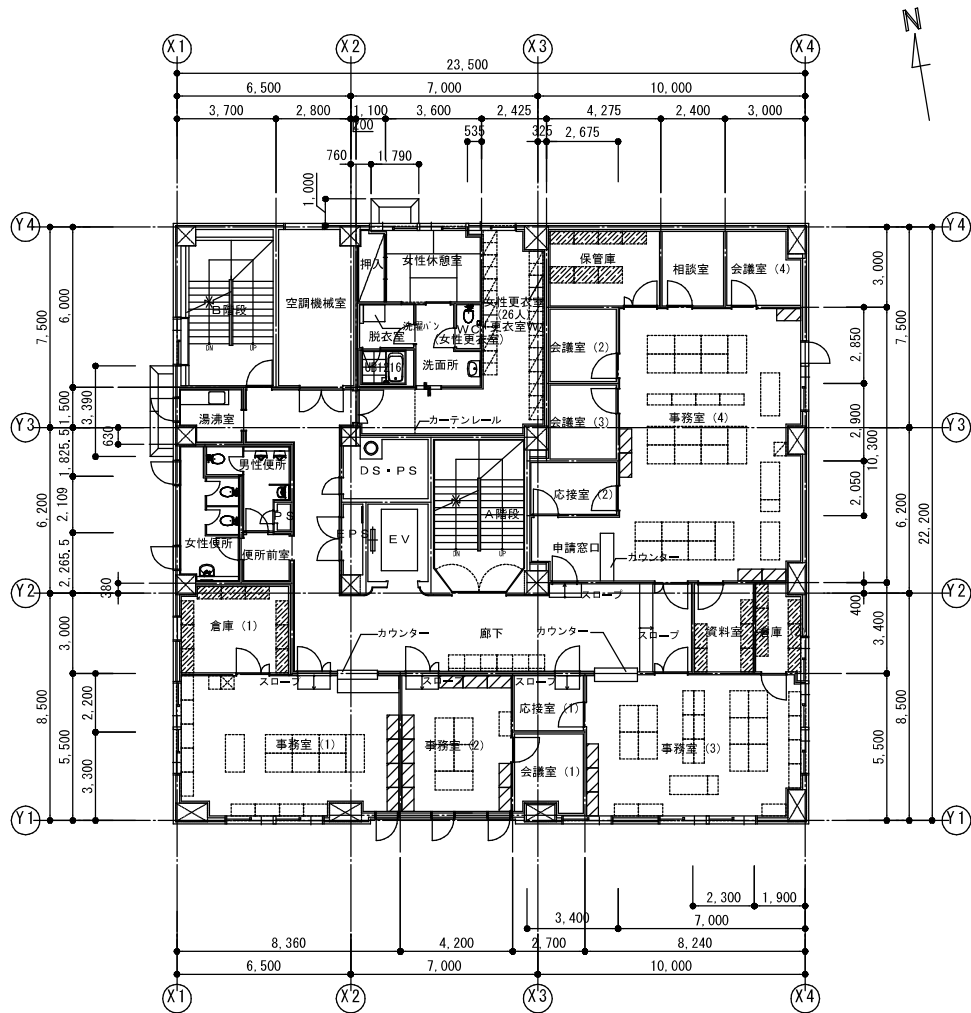


竣工図

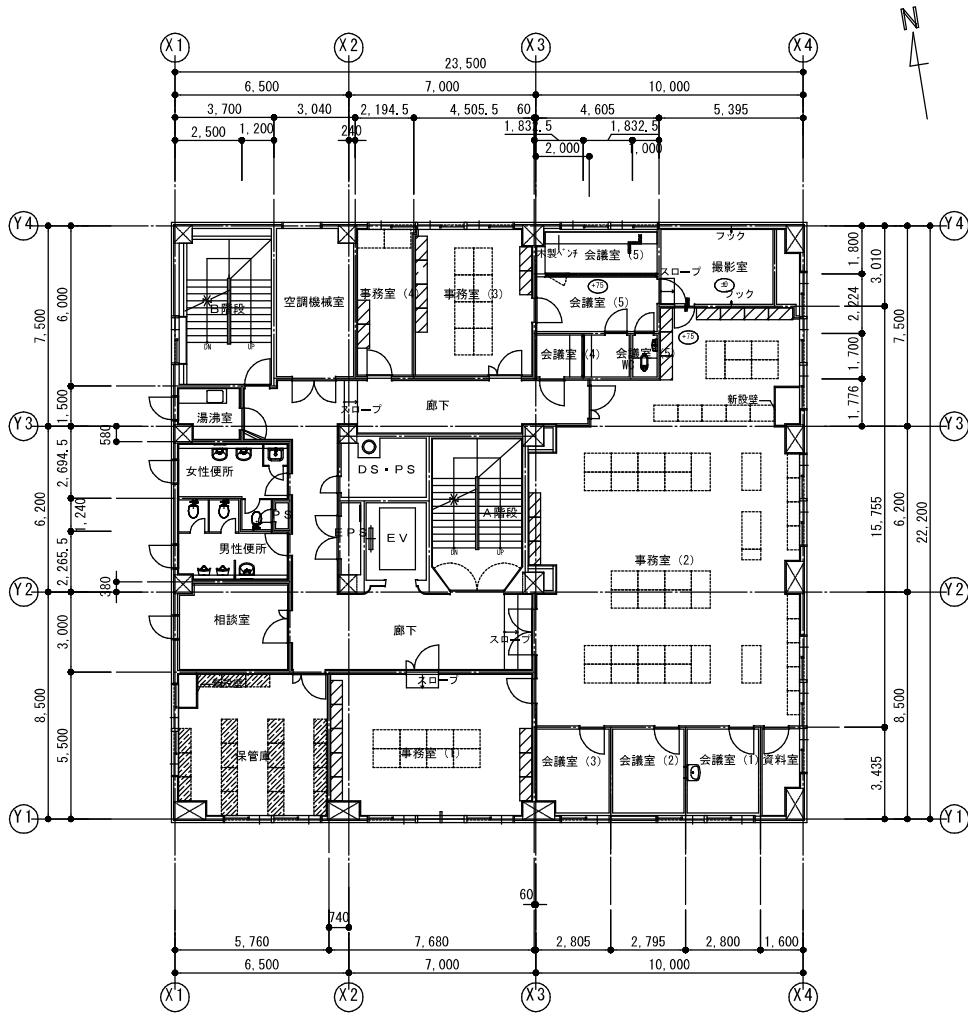

4階平面図 521.7㎡



改修後

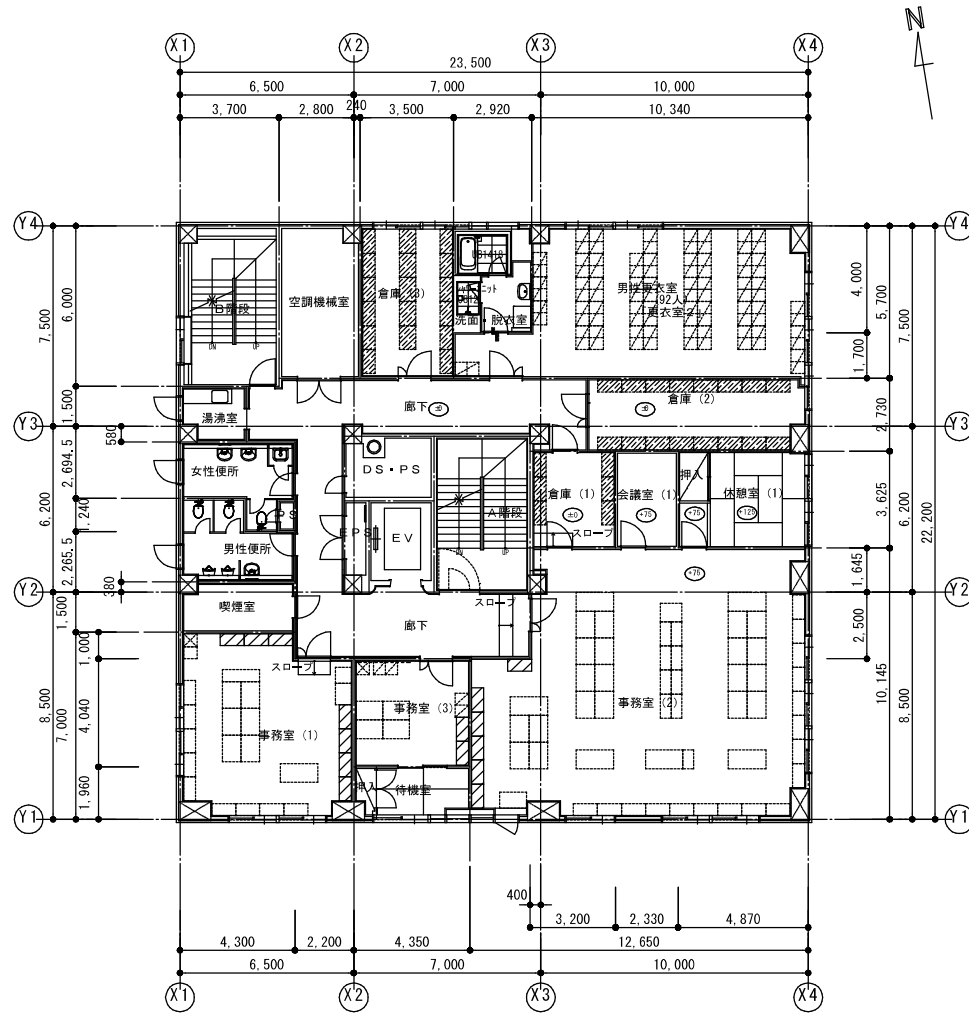

5階平面図 521.7㎡

改修後

竣工図

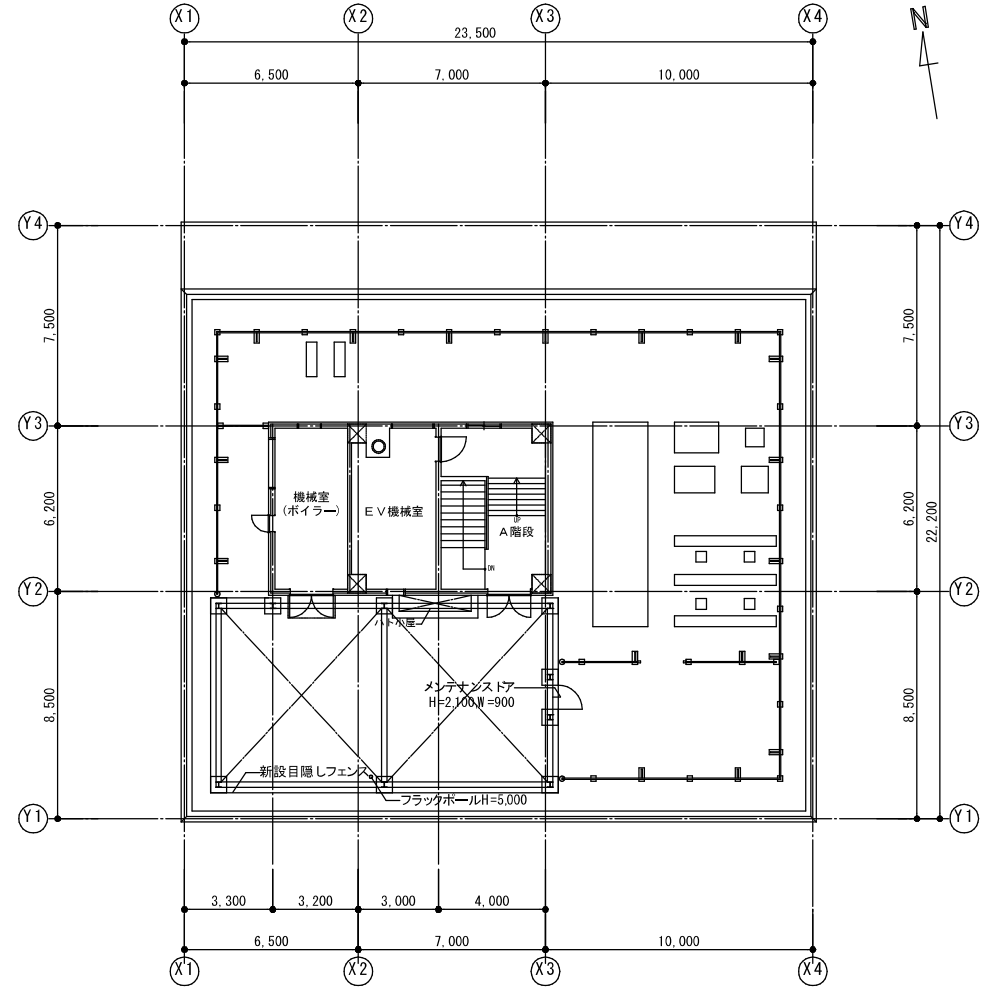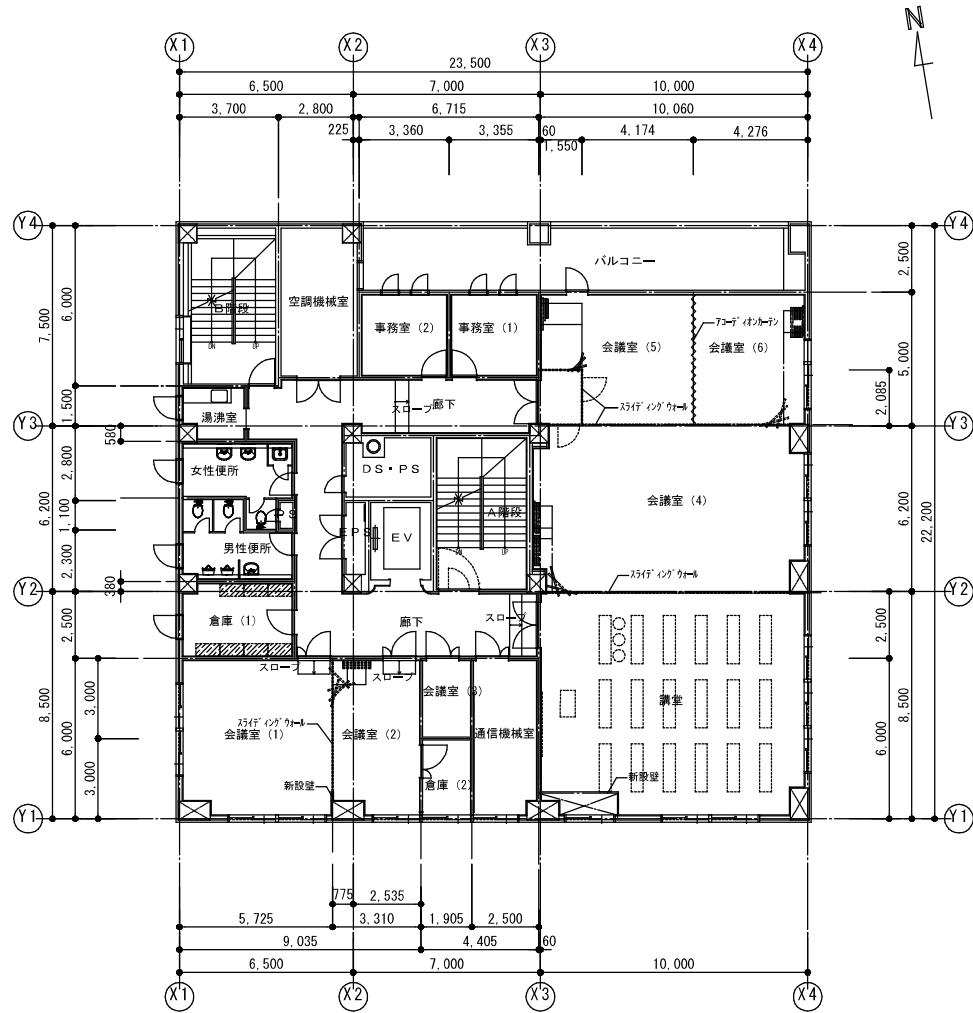

竣工図